

**TYPICAL SYSTEM PROFILE**  
(NOT TO SCALE)

NOTE: FILL MATERIAL IMMEDIATELY UNDER THE BED SHOULD BE MEDIUM TO COARSE SAND (0.5 mm - 2.0 mm). IF BED BOTTOM IS RAISED MORE THAN 3.0 FEET, PLACE COURSE TEXTURED SAND IN 16" LIFTS. CONSOLIDATE AND RAKE SURFACE PRIOR TO SETTING NEXT LIFT. EXTEND 5 FEET AROUND AND UNDER 3:1 SIDESLOPES.

E.S.H.W.T. = 281.5

**NOTES:**

1. PARCEL AREA: 1,487,644 SQ. FT. = 34.14 ACRES
2. NHDES SUBDIVISION APPROVAL NUMBER: SA2002003712  
PREVIOUS NHDES CONSTRUCTION APPROVAL NUMBER: CA2003051419  
NHDES DREDGE & FILL APPROVAL NUMBER: 2001-02490  
NHDES SITE SPECIFIC APPROVAL NUMBER: WPS-6240 (JULY 11, 2002)  
NHDES WELL APPROVAL NUMBER: 993704 - HADLEIGH WOODS
3. THE MAJORITY OF THE SUBJECT PROPERTY LIES WITHIN THE 140 SCS SOILS GROUP AS SHOWN ON THE SCS MAP FOR THE TOWN OF WINDHAM, NH. 140 - CHATFIELD-HOLLIS-CANTON COMPLEX
4. SYSTEM LOADING CALCULATION  
TOTAL NUMBER OF UNITS = 2  
TOTAL NUMBER OF PROPOSED BEDROOMS = (2 BDRMS/UNITS) 4 TOTAL  
4 BEDROOMS X 150 GPD/BEDRM. = 600 GPD  
PERCOLATION RATE; 12 MIN./INCH 32"  
NHDES MINIMUM LEACHING FIELD SIZE REQUIRED = 1,200 SQ. FT.  
ELJEN (TYPE "B") IN-DRAIN CALCULATION  
 $3.5 + [(12 \text{ MIN./INCH} \times 0.125)] \times 4 \text{ BDRMS} = 20 \text{ UNITS}$   
USE (24) TYPE "B" ELJEN IN-DRAIN UNITS, DISTRIBUTED LOCALLY BY HUBER DESIGN, INC. P.O. BOX 401, 175 PETERBOROUGH ROAD HANCOCK, NEW HAMPSHIRE 03449, PHONE: (603) 525-4320 OR APPROVED EQUAL.
5. SEPTIC TANK: USE (1) 2,000 GALLON 2-COMPARTMENT PRECAST CONCRETE SEPTIC TANK, AS MANUFACTURED AND DISTRIBUTED BY NEW ENGLAND PRECAST CORP., ROUTE 110 - AMESBURY, MASS. 01913  
PHONE: (800) 323-9487, OR APPROVED EQUAL.  
NOTE: ORDER TANK THAT WILL ACCOMMODATE ZABEL A300 FILTER  
DISTRIBUTION BOX: USE (1) 4 OUTLET PRECAST CONCRETE DISTRIBUTION BOX AS MANUFACTURED AND DISTRIBUTED BY ROTONDO & SONS, INC., OR APPROVED EQUAL.
6. INSTALL A ZABEL, MODEL A300, FILTER, OR APPROVED EQUAL, AT THE OUTLET OF THE PROPOSED SEPTIC TANK. ZABEL FILTERS DISTRIBUTED BY ZABEL ENVIRONMENTAL TECHNOLOGY 10409 WATTERSON TR. LOUISVILLE, KY 40299-3701, PHONE: (800) 221-5742.
7. DESIGN INTENT: BOTTOM OF THE PROPOSED LEACHING FIELD SHALL BE 1.5 FEET ABOVE THE EXISTING GRADE ON THE UPSLOPE SIDE.
8. NEAREST GROUP 6 SOIL OR NEIGHBORING WELL ARE ALL GREATER THAN 100 FEET AWAY FROM THE PROPOSED SEPTIC SYSTEM.
9. PIPES LEADING TO AND EXITING FROM THE PROPOSED SEPTIC TANK AND DISTRIBUTION BOX SHALL BE SEALED WITH AN APPROVED METHOD AS TO MAKE THE JOINTS WATERTIGHT.
10. SHOULD FAILURE OCCUR THIS SYSTEM SHALL BE REBUILT IN-PLACE.
11. PIPES LEADING TO AND EXITING FROM THE PROPOSED SEPTIC TANK, PUMP CHAMBER AND DISTRIBUTION BOX SHALL BE SEALED WITH AN APPROVED METHOD AS TO MAKE THE JOINTS WATERTIGHT.
12. PRIOR TO THE START OF CONSTRUCTION ALL BENCHMARKS SHALL BE VERIFIED FOR ACCURACY.
13. FOUNDATION DRAINS: NO FOUNDATION DRAINS SHALL BE INSTALLED WITHIN 25 FEET OF THE PROPOSED SEPTIC SYSTEM OR WITHIN 10 FEET OF THE PROPOSED SEPTIC TANK.
14. NO GARBAGE DISPOSAL IS PROPOSED WITH THIS DESIGN.
15. INSTALLATION OF THE ELJEN IN-DRAIN SYSTEM SHALL BE IN STRICT ACCORDANCE WITH THE ELJEN IN-DRAIN DESIGN AND INSTALLATION MANUAL FOR THE STATE OF NEW HAMPSHIRE, REVISED JUNE 05, 1995.
16. JOINTS ARE TO BE BELLED PVC OR STANDARD SLIP COLLARS.
17. ALL LATERALS TO EXIT THE DISTRIBUTION BOX AT SAME ELEVATION.
18. 2" OF COVER SHALL BE PROVIDED OVER THE FIELD WHERE MOTOR VEHICLE TRAFFIC WILL PASS OVER THE SEPTIC SYSTEM FIELD.
19. FILL SHALL NOT BE OF SATURATED SOIL.
20. ALL TREES, TOPSOIL, ROOTS, AND ORGANIC MATTER MUST BE REMOVED FROM THE AREA TO BE FILLED, OUT TO AND INCLUDING THE AREA UNDER THE IMPERMEABLE SOIL BARRIER. FILL MATERIAL TO BE CLEAN MEDIUM TO COARSE SAND, FREE OF TOPSOIL, HUMUS, DREGGINGS, OR STONES OVER 6" IN DIMENSION.
21. PROVIDE MEASURED TIES TO OWNER, ON THE LOCATION OF SEPTIC TANK ACCESS POINTS.
22. ANY DISCREPANCIES OR UNUSUAL CONDITIONS SHALL BE REPORTED TO THE DESIGNER BEFORE CONTINUING WITH THE INSTALLATION.
23. ALL PIPES EXITING THE PROPOSED DISTRIBUTION BOX SHALL HAVE AN "EQUALIZER" FLOW DIVIDER INSTALLED (OR APPROVED EQUAL). "EQUALIZER" FLOW DIVIDERS ARE DISTRIBUTED LOCALLY BY HUBER DESIGN, INC.

**TEST PIT "W"**  
(CONDUCTED ON NOVEMBER 15, 2001)

0-4" TOPSOIL (10YR 3/3) VERY DARK BROWN FINE LOAMY SAND, GRANULAR, FRABLE.

4"-30" (10YR 5/6) YELLOWISH BROWN FINE SANDY LOAM, GRANULAR, FRABLE, STONES AND FLAT BOULDERS PACKED IN.

30"-70" (10YR 6/4) LIGHT YELLOWISH BROWN FINE SAND, GRANULAR, FRABLE.

E.S.H.W.T.: @ 30"  
NO WATER OBSERVED  
REFUSAL: 70"  
RESTRICTIVE LAYERS: NONE ENCOUNTERED  
PERC. RATE: 8 MIN./INCH @ 35"

**TEST PIT "X"**  
(CONDUCTED ON NOVEMBER 15, 2001)

0-3" TOPSOIL (10YR 3/3) DARK BROWN, TOPSOIL, FINE LOAMY SAND, GRANULAR, FRABLE.

3"-32" (10YR 5/6) YELLOWISH BROWN FINE SANDY LOAM GRANULAR, FRABLE.

32"-56" (10YR 6/4) LIGHT YELLOWISH BROWN FINE SAND, GRANULAR, FRABLE.

E.S.H.W.T.: @ 32"  
NO WATER OBSERVED  
REFUSAL: @ 56"  
RESTRICTIVE LAYERS: NONE ENCOUNTERED  
PERC. RATE: 8 MIN./INCH @ 34"


**TEST PIT "38/40"**  
(CONDUCTED ON NOVEMBER 15, 2001)

0-3" TOPSOIL (10YR 3/3) DARK BROWN, TOPSOIL, FINE LOAMY SAND, GRANULAR, FRABLE.


3"-32" (10YR 5/6) YELLOWISH BROWN FINE SANDY LOAM GRANULAR, FRABLE.

32"-42" (10YR 6/4) LIGHT YELLOWISH BROWN FINE SAND, GRANULAR, FRABLE.

E.S.H.W.T.: @ 32"  
NO WATER OBSERVED  
REFUSAL: @ 42"  
RESTRICTIVE LAYERS: NONE ENCOUNTERED  
PERC. RATE: 12 MIN./INCH @ 32"

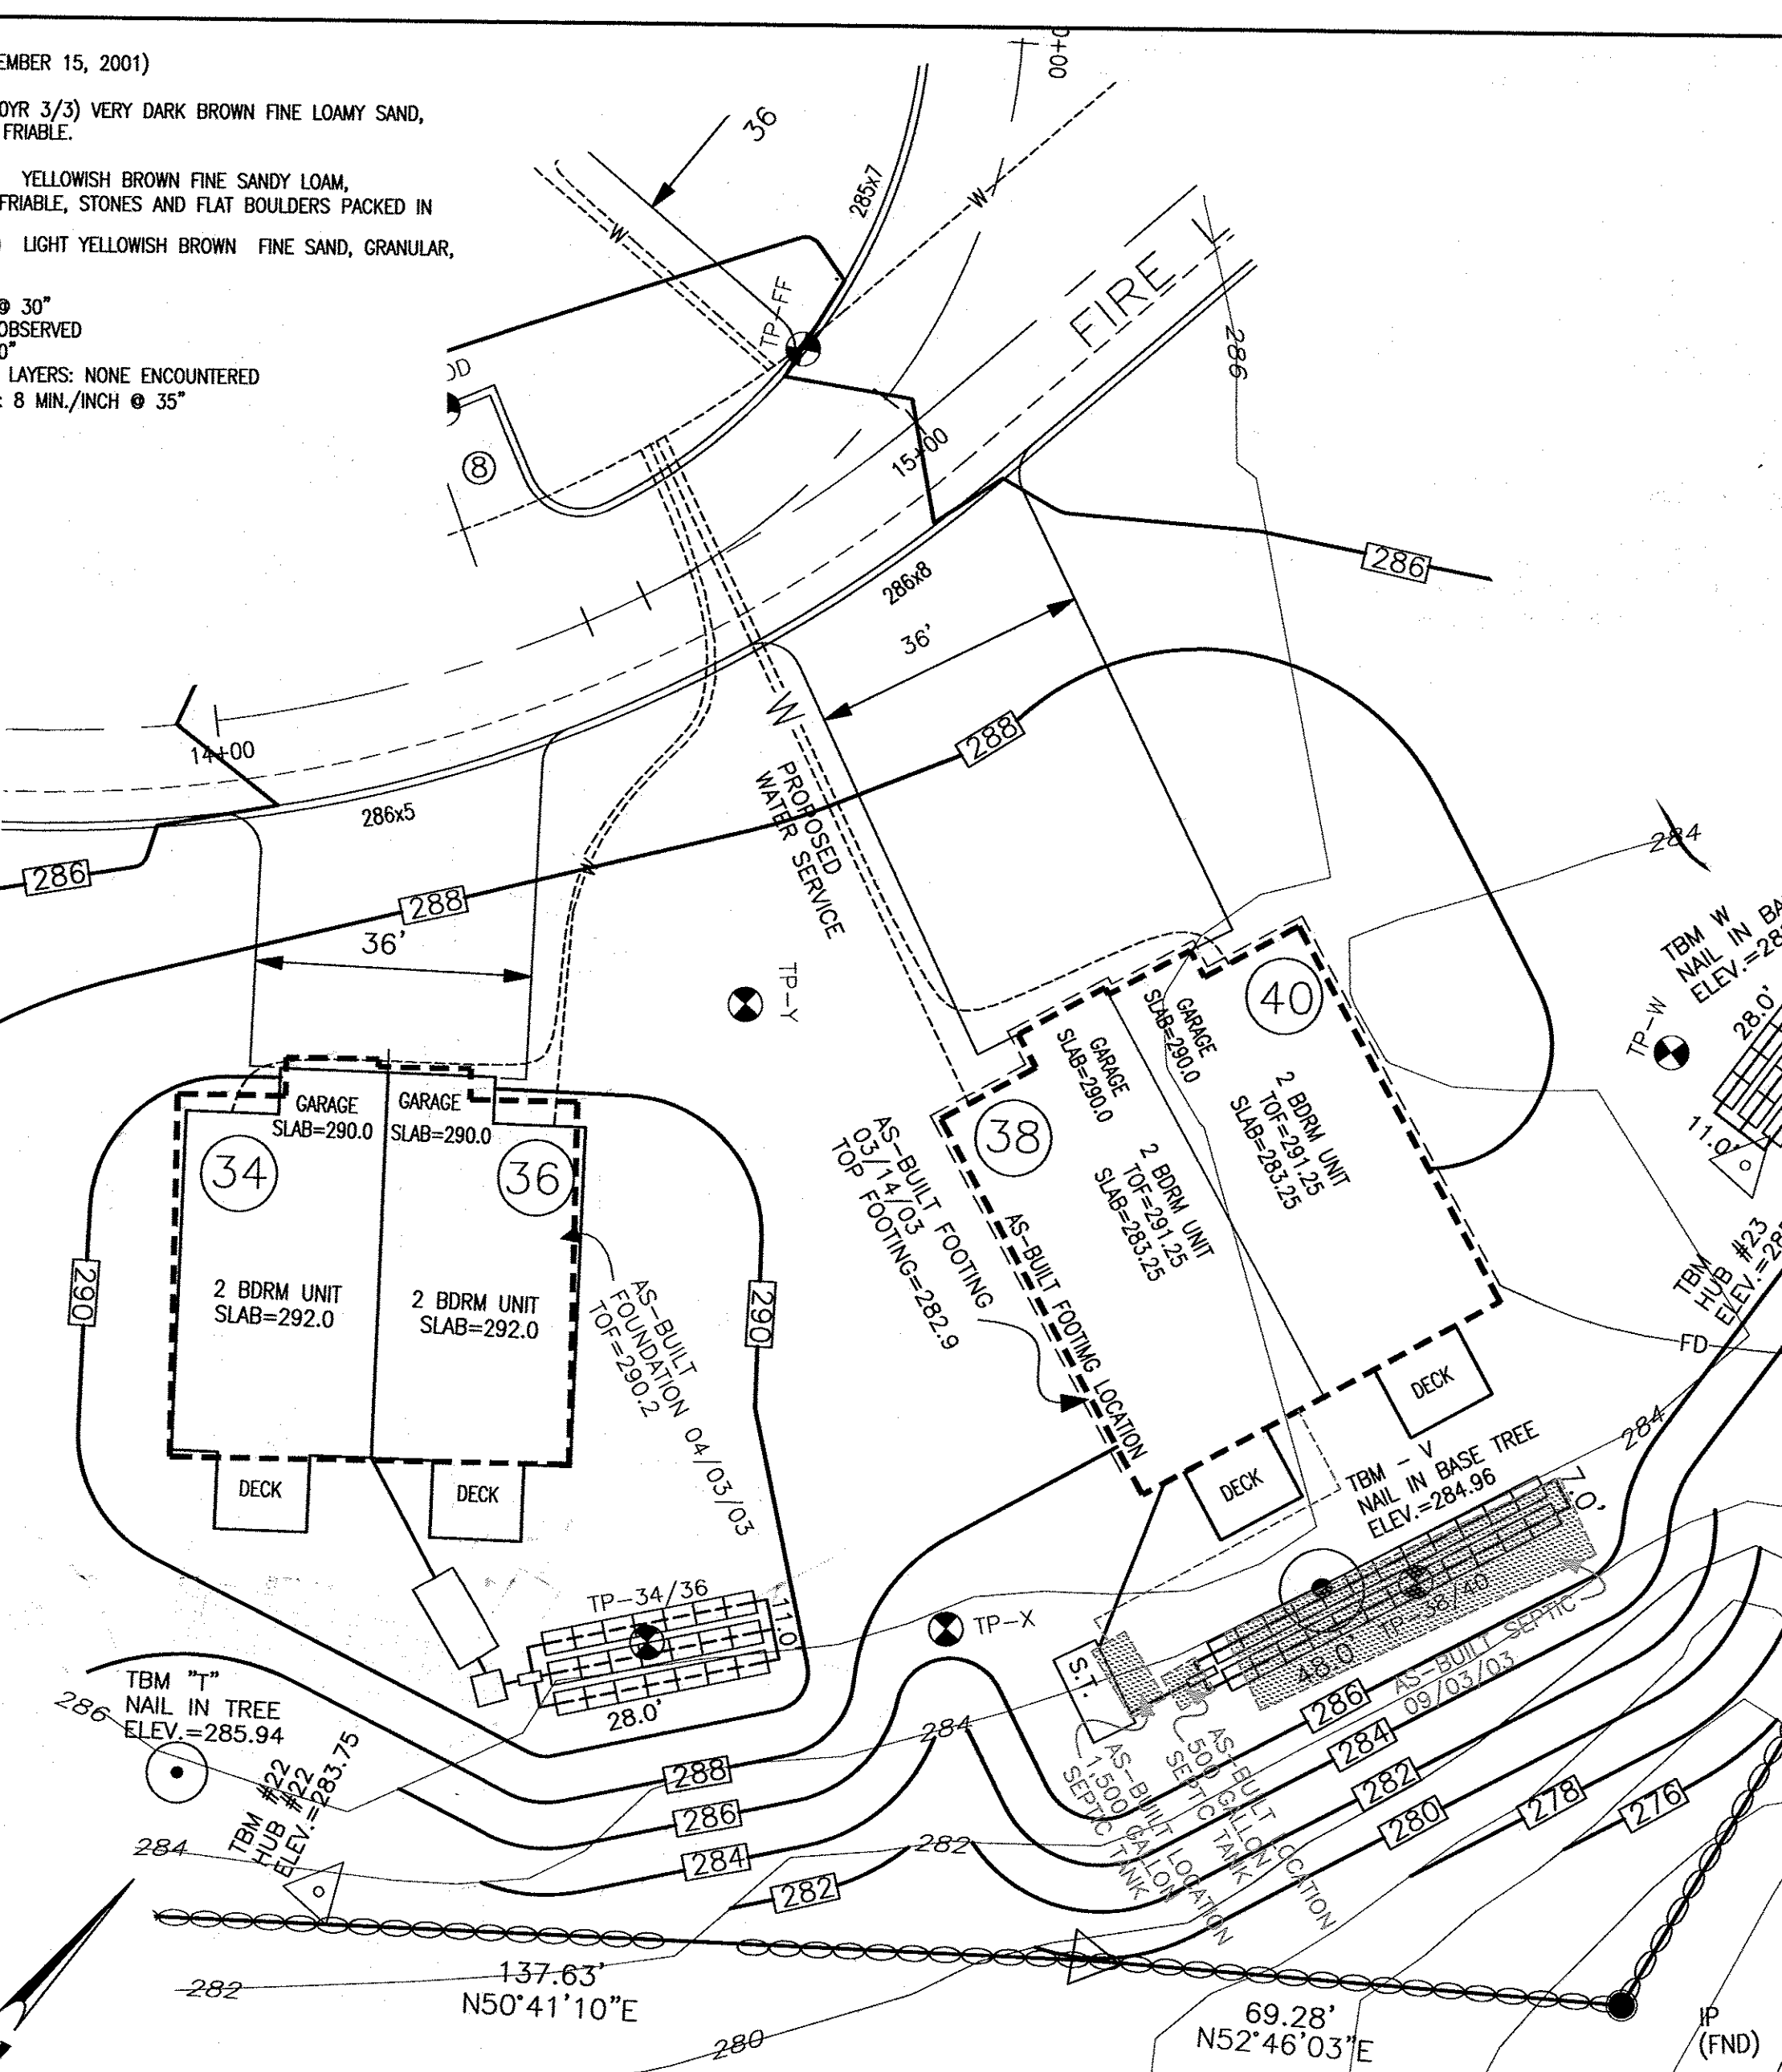


**TAX MAP 3-B LOT 265**  
1,487,644 SQ. FT.  
34.14 ACRES

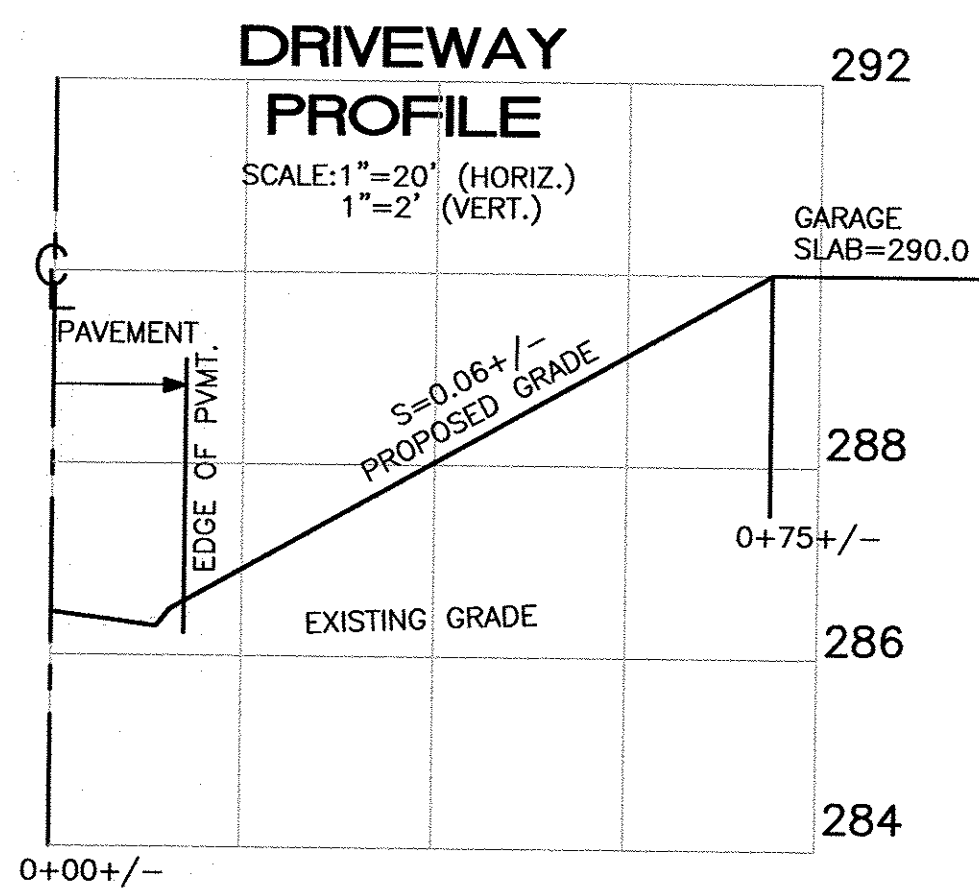

I CERTIFY THAT THE AS-BUILT SEPTIC TANK AND FIELD LOCATIONS SHOWN WERE TAKEN FROM AN ACTUAL FIELD LOCATION CONDUCTED ON SEPTEMBER 03, 2003

NEW HAMPSHIRE  
Designer of  
Subsurface Disposal  
Systems  
Joseph Maynard  
No. 1155  
Waterbury, Vermont  
9/3/03

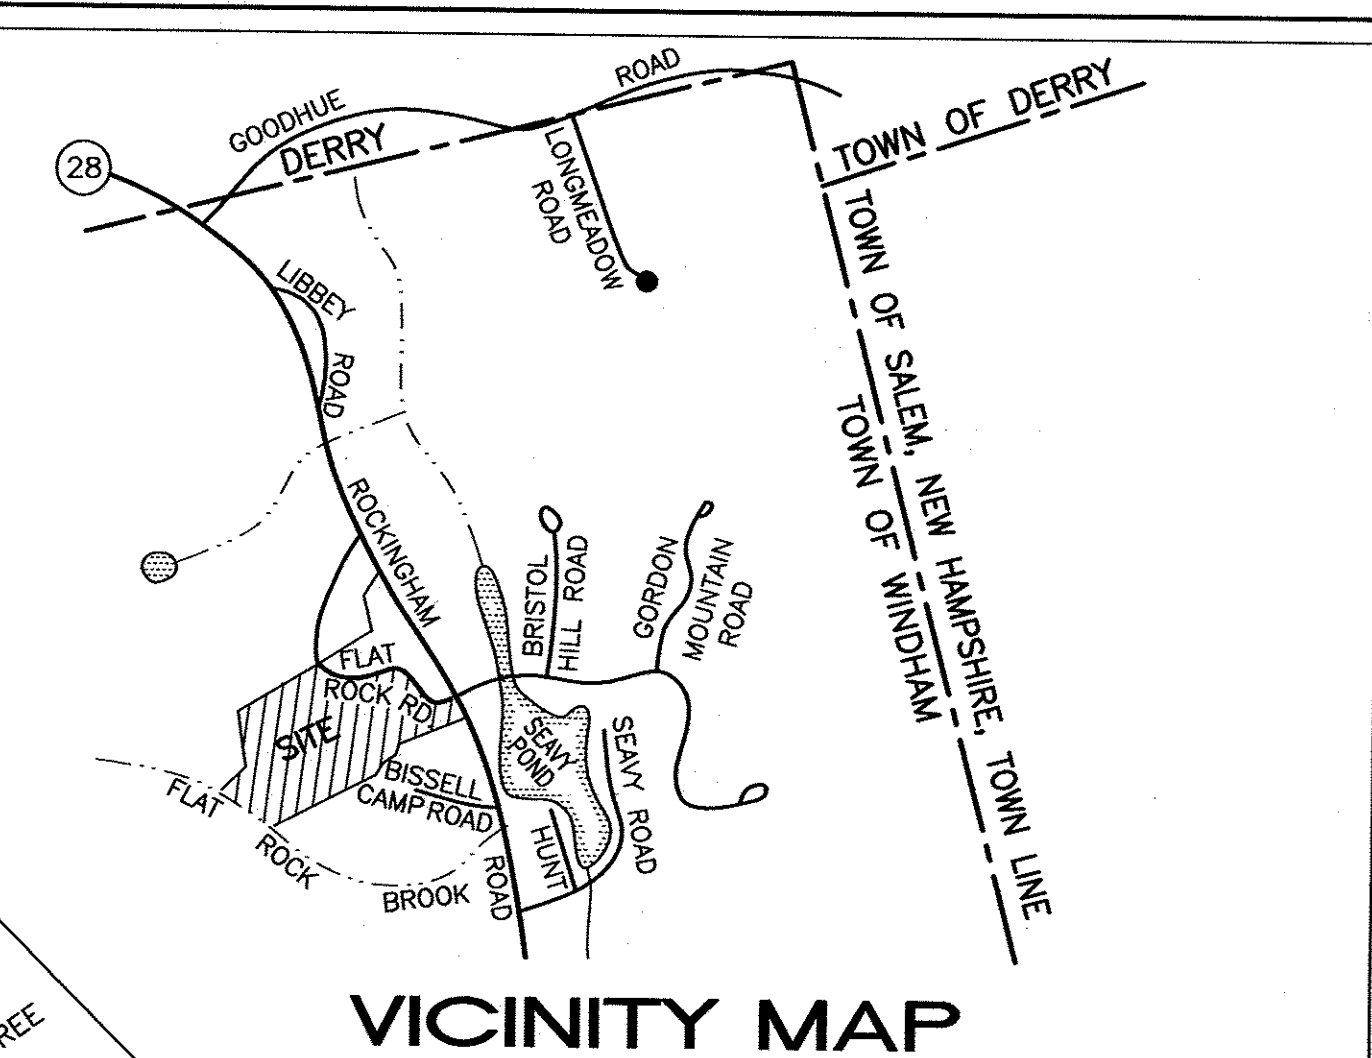

**PLAN REFERENCES:**

- SEE PLANS TITLED "SITE PLANS TAX MAP 3-B LOT 265 HADLEIGH WOODS WINDHAM, NEW HAMPSHIRE" OWNER: LOT 3-B-200 & 3-B-265 ADDRESS: 8 DEERWOOD HOLLOW CHESTER, NEW HAMPSHIRE 03036 SHEETS 1-15 OF 15 DATED MARCH 27, 2002 AS PREPARED BY THIS OFFICE.
- SEE PLAN TITLED "SUBDIVISION PLAN TAX MAP 3-B LOT 200 & TAX MAP 3-B LOT 265 TAX MAP 3-B LOT 271, NH ROUTE 28 - ROCKINGHAM ROAD WINDHAM, NEW HAMPSHIRE 03087" OWNER: LOT 3-B-200 & LOT 3-B-265 H&B HOMES CORP. ADDRESS: 8 DEERWOOD HOLLOW CHESTER, NEW HAMPSHIRE 03036 OWNER: LOT 3-B-271 ANTHONY PETA ADDRESS: 30 BRANDYWINE COMMON DERRY, NEW HAMPSHIRE 03038 SHEETS 1-12 OF 12 DATED: MARCH 27, 2002 AS PREPARED BY THIS OFFICE.

**TEST PIT "X"**  
(CONDUCTED ON NOVEMBER 15, 2001)

0-3" TOPSOIL (10YR 3/3) DARK BROWN, TOPSOIL, FINE LOAMY SAND, GRANULAR, FRABLE.

3"-32" (10YR 5/6) YELLOWISH BROWN FINE SANDY LOAM GRANULAR, FRABLE.

32"-56" (10YR 6/4) LIGHT YELLOWISH BROWN FINE SAND, GRANULAR, FRABLE.

E.S.H.W.T.: @ 32"  
NO WATER OBSERVED  
REFUSAL: @ 56"  
RESTRICTIVE LAYERS: NONE ENCOUNTERED  
PERC. RATE: 8 MIN./INCH @ 34"

**TEST PIT "38/40"**  
(CONDUCTED ON NOVEMBER 15, 2001)

0-3" TOPSOIL (10YR 3/3) DARK BROWN, TOPSOIL, FINE LOAMY SAND, GRANULAR, FRABLE.

3"-32" (10YR 5/6) YELLOWISH BROWN FINE SANDY LOAM GRANULAR, FRABLE.

32"-42" (10YR 6/4) LIGHT YELLOWISH BROWN FINE SAND, GRANULAR, FRABLE.

E.S.H.W.T.: @ 32"  
NO WATER OBSERVED  
REFUSAL: @ 42"  
RESTRICTIVE LAYERS: NONE ENCOUNTERED  
PERC. RATE: 12 MIN./INCH @ 32"

**SEPTIC SYSTEM PLAN**  
**TAX MAP 3-B LOT 265**  
**UNITS 38/40 HADLEIGH ROAD**  
**WINDHAM, NEW HAMPSHIRE 03087**  
OWNER OF RECORD/PREPARED FOR  
**H&B HOMES CORP.**  
8 DEERWOOD HOLLOW  
CHESTER, NEW HAMPSHIRE 03036  
R.C.R.D. BOOK 3575/PAGE 2759  
SCALE: 1"=20' SHEET 1 OF 1 MARCH 20, 2003

AS-BUILT SEPTIC LOCATION	09-03-03
REVISE DESIGN/NO PUMP	06-16-03
REVISIONS	DATE

**BENCHMARK ENGINEERING, INC.**  
Consulting Engineers Land Planners  
1C Commons Drive, Suite 17  
Londonderry, New Hampshire 03053  
Phone: (603) 437-5000  
Fax: (603) 437-3078